

ATTACHMENT #2




 1500 SOUTH 4800 WEST STE. D
 SALT LAKE CITY, UT 84119
 P: (801) 401-5500
 F: (801) 401-5501

NO.	DATE	BY	DESCRIPTION
1	08/26/11	BT	REPLACED 45° CURVES WITH 90°
2	09/27/11	BT	UPDATED LAYOUT PER MARKUP
3	11/28/11	BT	AS BUILT

DRAWN BY: TURNER
 CHECKED BY: / /
 DATE: 07/28/11
 PROJECT TITLE: DOT/TA SECURITY SCREENING DEVELOPMENT PROJECT JUNEAU INTERNATIONAL AIRPORT
 DRAWING DESCRIPTION: BAGGAGE FLOW EDS SCREENING

UNLESS OTHERWISE NOTED:
 ALL ANGLES 45°
 DEBURR ALL SHARP EDGES
 CHAMFER ALL CORNERS AND
 FINISH AND STRAIN IF POSSIBLE
 ALL SURFACES SHALL BE FINISHED
 FREE FROM SURFACE DEFECTS

SCALE: 1/8" = 1'-0"
 DRAWING NUMBER: 5136-801
 SHEET 1 OF 1

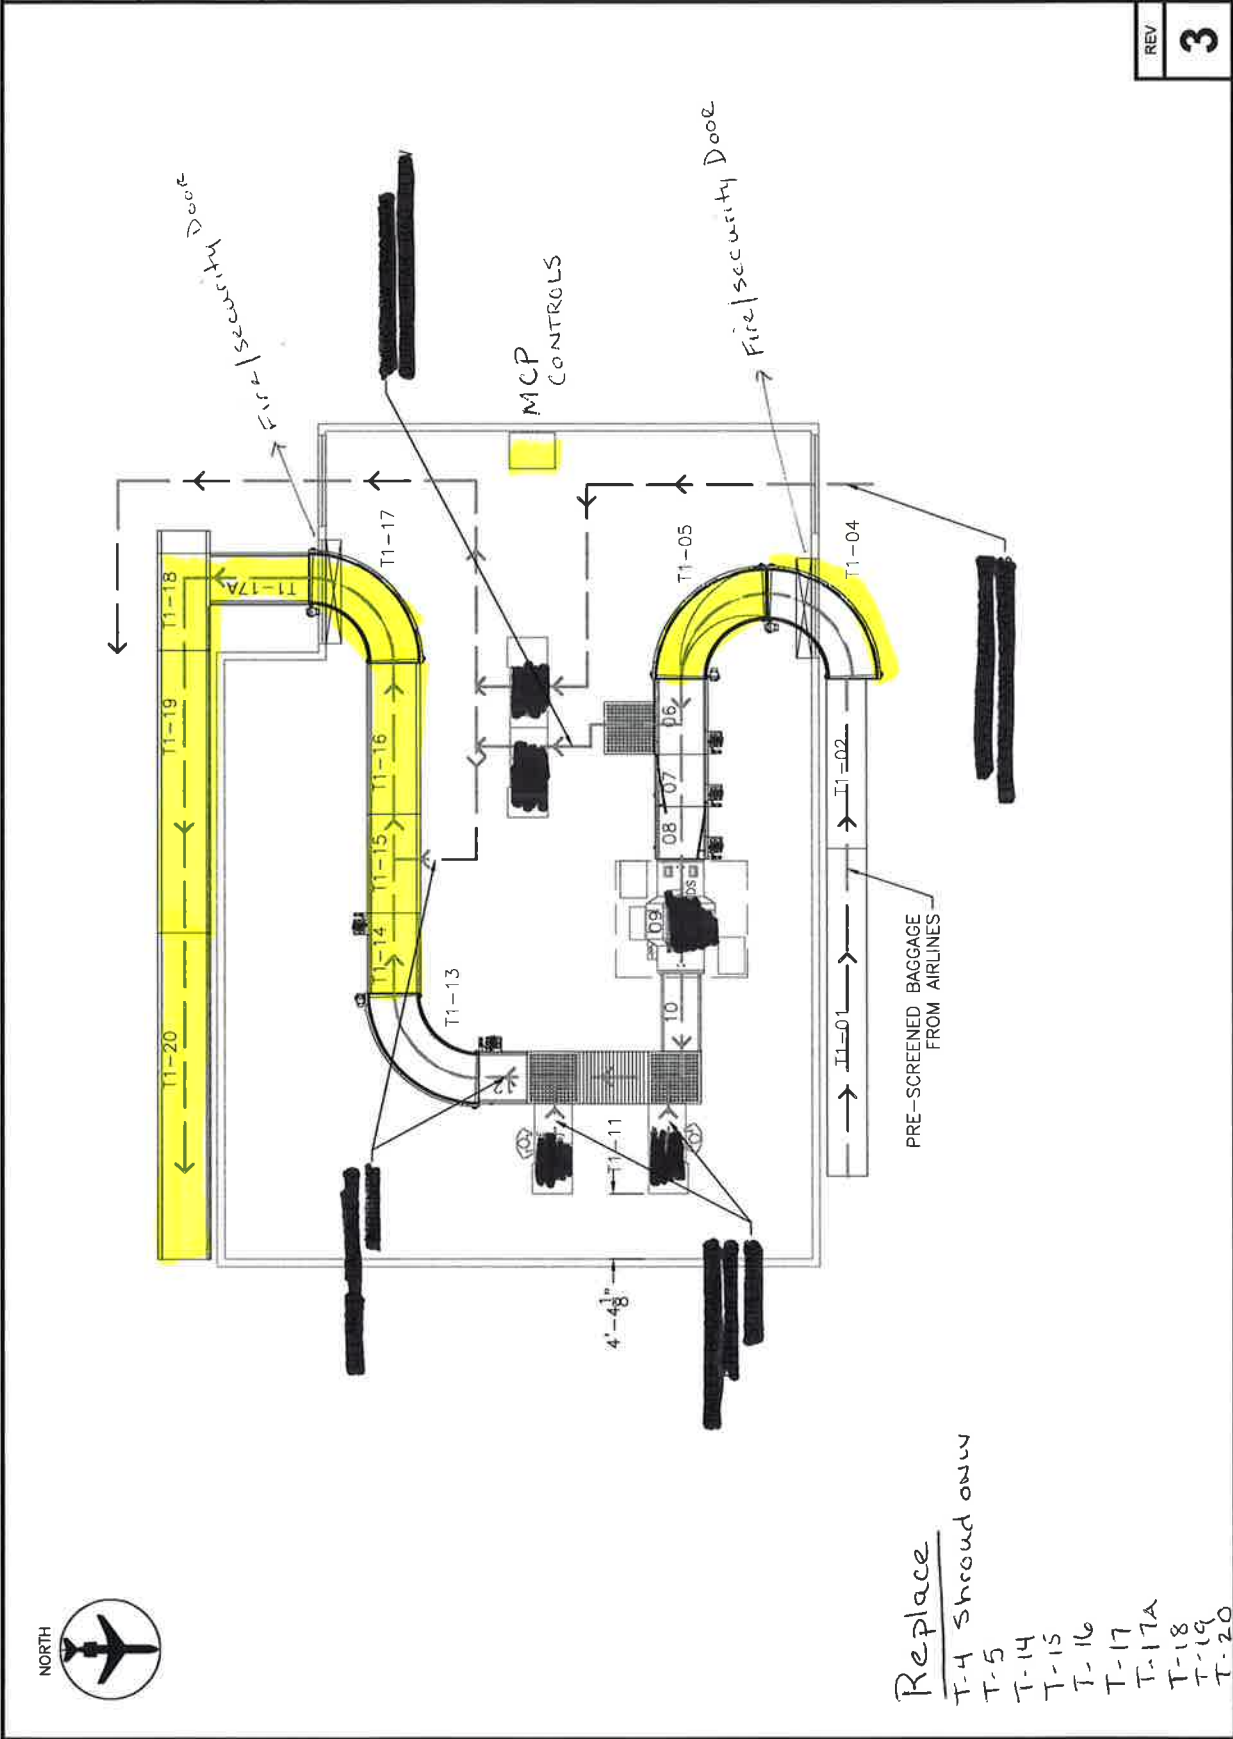

REV	DESCRIPTION
3	

Replace
 T-4 Shroud only
 T-5
 T-14
 T-15
 T-16
 T-17
 T-17A
 T-18
 T-19
 T-20