

ADDENDUM TO THE REQUEST FOR QUOTE

for the

Electric Vehicle Charging Station Installation Marine Parking Garage RFQ No. E15-117

ADDENDUM NO.:

THREE

CURRENT QUOTE DUE DATE:

September 23, 2014

PREVIOUS ADDENDA: TWO

ISSUED BY:

City and Borough of Juneau ENGINEERING DEPARTMENT

155 South Seward Street Juneau, Alaska 99801

DATE ADDENDUM ISSUED:

September 22, 2014

The following item of the Request for Quote is modified as herein indicated. All other items remain the same. This addendum has been issued and is posted online. Please refer to the CBJ Engineering Contracts Division webpage at:


http://www.juneau.org/engineering ftp/contracts/Contracts.php

Item No. 1 Permit number BLD 20140600 shall be attached to the bid documents.

Greg Smith, Contract Administrator

Date: 9/22/14

Total number of pages contained within this Addendum: Four

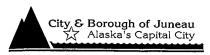

BUILDING PERMIT

Permit No. BLD20140600

* NOTE: "Building Permit" is a generic term which includes Building Safety Inspection, Grading Permits, and permits for Electrical, Plumbing and Mechanical work.

Your special attention is called to the following:

This permit is granted on the express conditions that the construction shall, in all respects, conform to the ordinances of the City and Borough of Juneau. It may be revoked at any time upon violation of any of said ordinances.

The granting of this permit does not authorize the violation of any federal, state or local law regulating construction for the violation of the terms of any deed or covenent or any zoning or other regulation.

If plan review was required, this permit must be attached to the approved drawings. The permit, plans and record of inspections must be available on site at all times while the construction is in progress and before final inspection.

The yellow posting notice must be prominently displayed to show a permit has been issued and to assist the inspectors in location of the project. This permit becomes null and void if work or construction authorized is not commenced within one year or if work or construction is suspended or abandoned for a period of one year at any time after work has commenced.

Note: City Ordinances REQUIRE a Final Inspection be approved for every Building Permit.

Inspections

Inspections can be arranged by telephoning 586-1703 or by written or faxed notification.

The Online Building Inspection Request Form is at: www.juneau.org/permits/inspect_request.php.

Work shall not proceed until the inspector has approved the various stages of construction. An approved Final Inspection is required.

Call before 7:00 AM for same day inspections.

Please provide the following information: 1 Permit Number, 2 Address, 3 Type of Inspection, 4 Date and Time and 5 Contact Name and Phone Number.

Permit Nu	ess: 290 MARINE WAY Imber: BLD20140600 Cription: Install Electric Veh	Issued Date : 09/22/2014 Parcel No: 1C070K830020		
Parcel Info	rmation : TIDELANDS AD	DITION BL 83 LT 2 - 6		
Setbacks:	Zone: :	· · · · · · · · · · · · · · · · · · ·		
	Front: 10.00 Ft.	Side 1: 10.00 Ft.		
	Rear: 10.00 Ft.	Side 2: 10.00 Ft.		•

Comments:

Owner:

Fee Type

Project Conditions and Holds:

B-Electrical Final

CITY AND BOROUGH OF JUNEAU LANDS AND RESOURCES

155 S SEWARD ST JUNEAU AK 99801

Date

Receipt

Street Side: 10.00 Ft.

Applicant: CITY & BOROUGH OF JUNEAU ENGINEERING DEPARTMENT 155 S SEWARD ST JUNEAU AK 99801

Valuation for Permit Fee Calculations:

<u>S.F.</u>	<u>Type</u>		<u>Rate</u>	<u>Amour</u>
				10,000.00
		Total Valuation:		\$10,000.0
	<u>S.F.</u>	<u>S.F.</u> <u>Type</u>		


Amount

B-Rough Electrical

None.

Inspections Required: Call for inspection before covering or concealing any of the work described below. Inspections may be combined.

Permit Center 230 S. Franklin, 4th Floor Marine View Center PHONE 586-0770 INSPECTIONS 586-1703

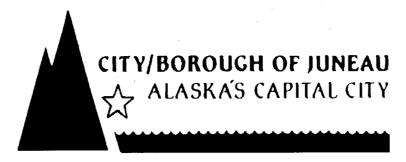

POSTING NOTICE OF BUILDING PERMIT

BLD20140600

Permit No.

Install Electric Vehicle Charging Station


For

290 MARINE WAY


Address


9/22/2014

Inspections will not be performed without CBJ approved plans on site.

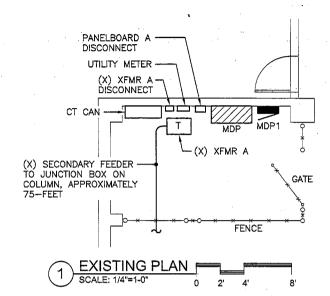


EXISTING SINGLE LINE DIAGRAM

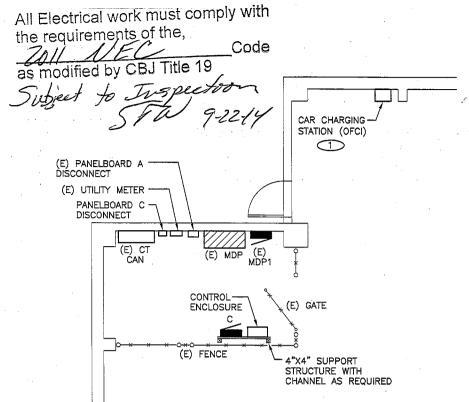

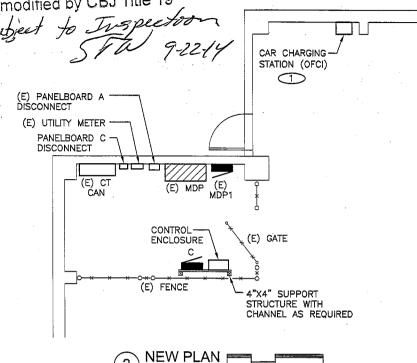

SCALE: 1/4"=1'0" 0 2' 4'

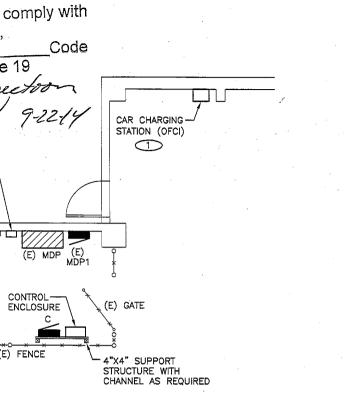

LEGEND			
SYMBOL	DESCRIPTION		
-@	SPECIAL PURPOSE RECEPTACLE		
M	UTILITY METER		
 TC	TIME CLOCK		
20/1 6 6 H O A	CIRCUIT BREAKER		
0 0	HAND-OFF-AUTO SWITCH		
	NORMALLY OPEN CONTACTS		
©	CONTACTOR COIL		
400AS	FUSED SWITCH		
Ī	BRANCH CIRCUIT PANELBOARD TRANSFORMER		
	SERVICE OR DISTRIBUTION EQUIPMENT		

ABBREVIATIONS				
A AS	AMPERES AMP SWITCH			
C CT	CONDUIT CURRENT TRANSFORMER			
(E) G	EXISTING			
	GROUND			
OFCI	OWNER FURNISHED, CONTRACTOR INSTALLED			
Р	PHASE			
v	VOLTS			
(X) ·	REMOVE			

CONTROL ENCLOSURE

1"C, 4#8, 1#10G

CONTACTOR

(2)

lil₍₂₎

SIU


DUAL CAR CHARGING STATION

(OFCI)

Φ

NOTES:

- COORDINATE EXACT LOCATION WITH THE CITY AND BOROUGH OF JUNEAU PROJECT REPRESENTATIVE.
- CONDUCTORS: COPPER, STRANDED, XHHW,
- HANGERS AND SUPPORTS: HOT-DIP GALVANIZED AFTER FABRICATION; STAINLESS STEEL HARDWARE.
- RACEWAYS: GALVANIZED RIGID STEEL.
- BOXES AND ENCLOSURES: GALVANIZED STEEL, FINISHED WITH MANUFACTURER'S STANDARD
- TIME CLOCK: 365/7 DAY CONTROL WITH HOLIDAY SCHEDULE, TORK DW SERIES, OR EQUAL.
- HAND-OFF-AUTO SWITCH: HEAVY-DUTY, OILTIGHT
- PANELBOARD: 100A, 120/208V, 3—PHASE, 4—WIRE, 30—CIRCUITS, MAIN LUG ONLY, BOLT—ON CIRCUIT BREAKERS, HINGED COVER.

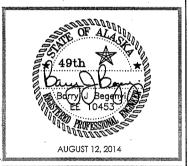




DESCRIPTION

DATE

			Anna		
OG	PROJECT Marine View Parking Garage Car Charging Station SHEET TITLE Plans and Single Line Diagrams				

DRAWING NUMBER SCALE DATE AUG 2014

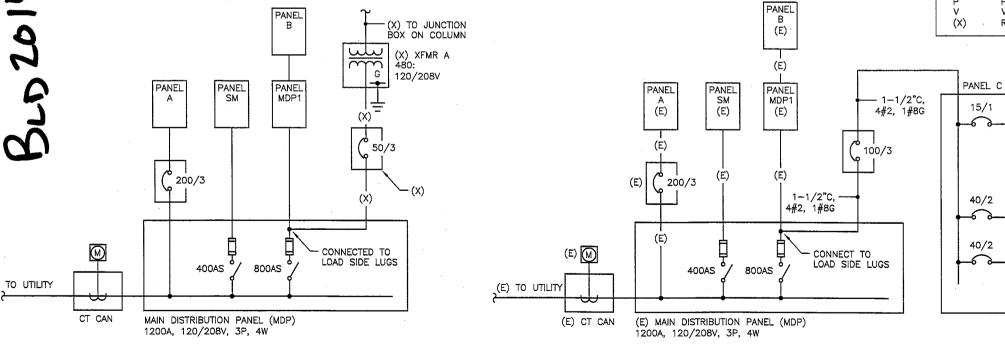

INTAKE REVIEW Gen Eng. NEW SINGLE LINE DIAGRAME IVED POC IOC SEP 2 2 2014 Tech.

15/1

40/2

PERMIT CENTER/CDD